





FOR CONSTRUCTION NOTES SEE SHEET ONE.

JENNINGS-HALDERMAN INC.  
 136 W. WASHINGTON, SANTA ANA  
 HUGH E. HALDERMAN RCE 8793 DATE 3-9-62

REVISIONS		
MARK	DATE	DESCRIPTION

CITY OF RIVERSIDE  
 DEPARTMENT OF PUBLIC WORKS  
 SEWER PLAN & PROFILE  
 TRACT NO. 2370  
 ROSEHILL DRIVE FROM  
 Station 0-05 to 8+82.38  
 HORIZ. SCALE: 1" = 40' VERT. SCALE: 1" = 4'  
 DESIGNED BY: [Signature]  
 DRAWN BY: [Signature]  
 RECOMMENDED BY: [Signature]  
 ASSISTANT CITY ENGINEER  
 APPROVED BY: [Signature]  
 DIRECTOR OF PUBLIC WORKS  
 DATE: 6-29-62  
 No 9-353  
 SHEET 2 OF 3 SHEETS

\* As built 6/29/62 Rk

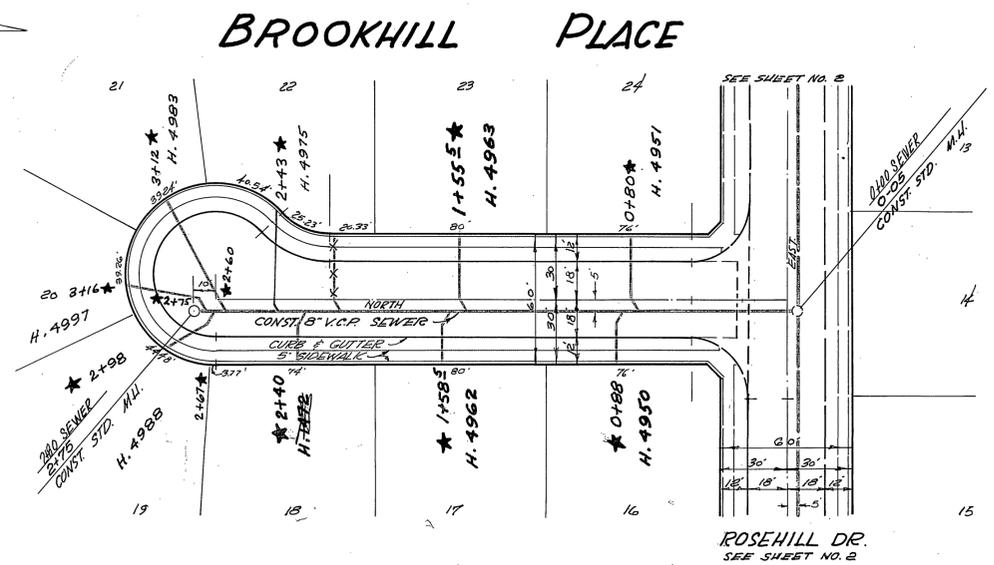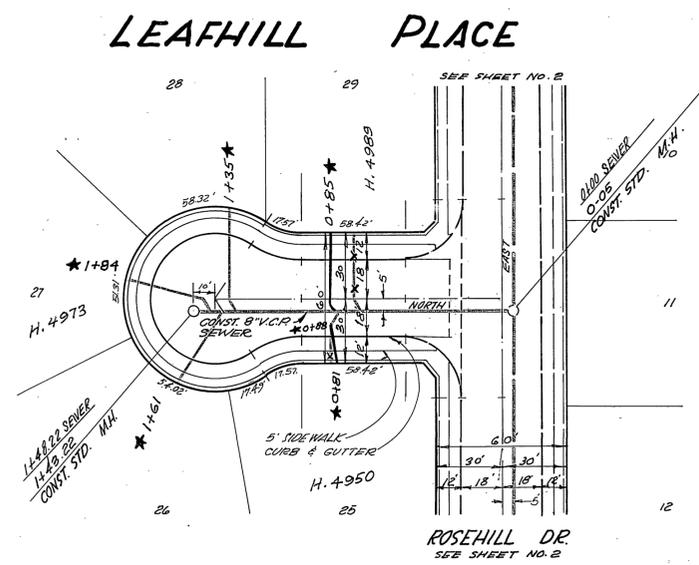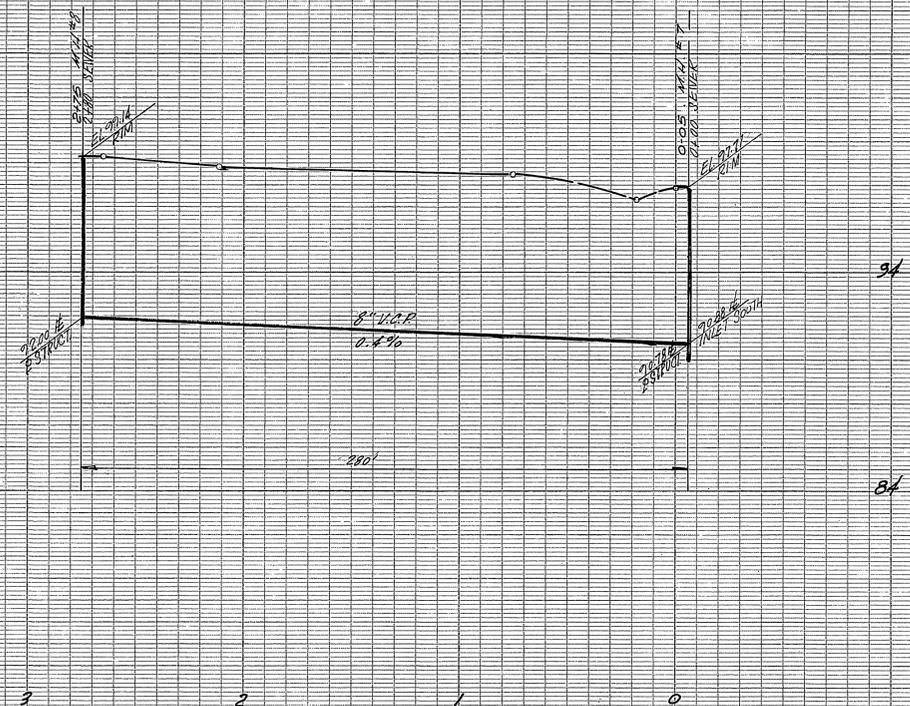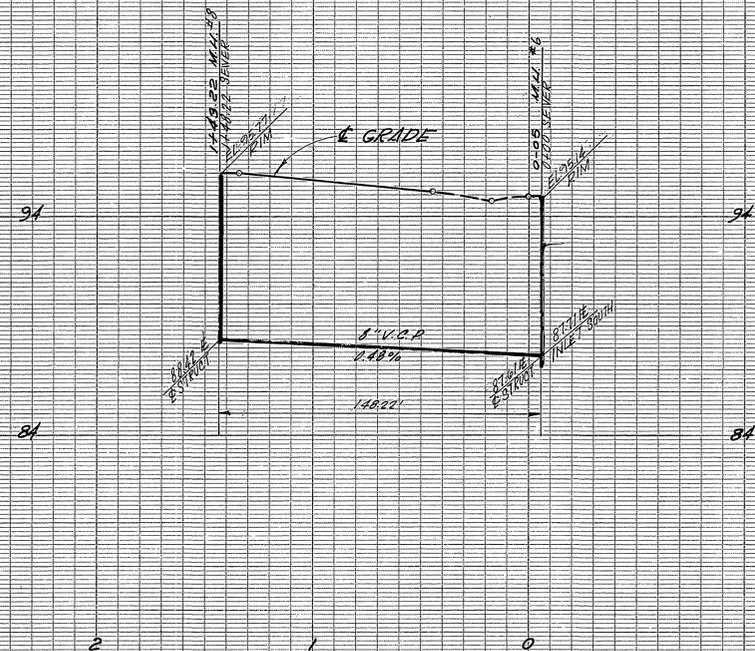

FOR CONSTRUCTION NOTES SEE SHEET ONE

\* = As built 6/29/62 RK

**JENNINGS ~ HALDERMAN INC.**  
 136 W WASHINGTON, SANTA ANA  
 HUGH E HALDERMAN RCE.B793 DATE 3-9-62

**CITY OF RIVERSIDE**  
**DEPARTMENT OF PUBLIC WORKS**

SEWER PLAN & PROFILE  
 TRACT NO. 2370  
 BROOKHILL PLACE FROM  
 STATION 0+05 TO 2+75  
 LEAFHILL PLACE FROM  
 STATION 0+05 TO 1+43.22  
 HORIZ. SCALE: 1" = 40' VERT. SCALE: 1" = 4'

REVISIONS	
MARK	DATE DESCRIPTION

DESIGNED BY: [Signature]  
 DRAWN BY: [Signature]  
 CHECKED BY: [Signature]  
 RECOMMENDED BY: [Signature]  
 ASSISTANT CITY ENGINEER

APPROVED BY: [Signature]  
 DIRECTOR OF PUBLIC WORKS  
 DATE: 4-22-62

No 8-353  
 SHEET 3 OF 3 SHEETS